


SUITE 350

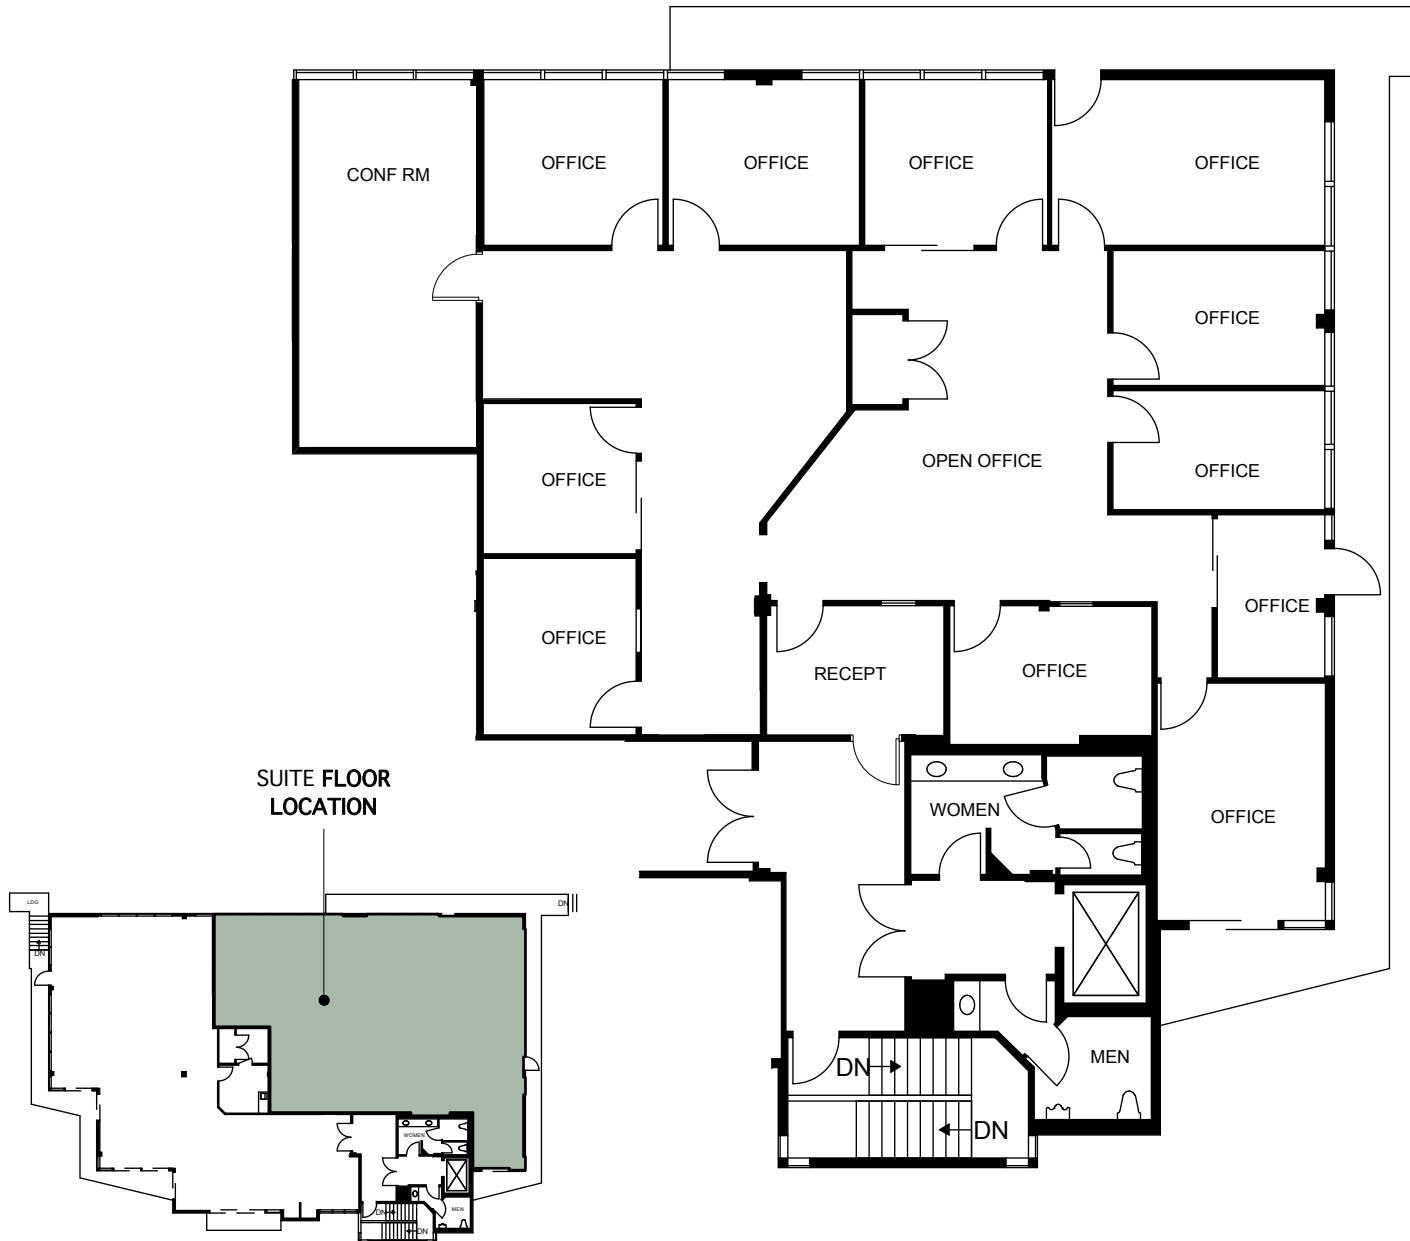

KEY PLAN FLOOR - 3



TRANSWESTERN®

500 Ygnacio Valley Road
Suite 100
Walnut Creek, Ca 94596
T (925) 357-2000
F (925) 357-2001

LEASING AGENTS

Ed Del Beccaro
(925) 357-2019

Matt Hurd
(925) 357-2013

**Oak Hill West
Office Park**

3736-3746 Mt. Diablo Blvd.
Lafayette, CA

Thjird Floor

Approximate Area Calculations
Subject To Verification:

3,172 rsf

As-built Plan To Be Verified

This information displayed while not guaranteed has been secured by sources we believe to be reliable. This information is subject to errors & omissions. Any tenant should conduct their own investigation.

Plan Revision - 10-15-14